


Sample As Built Lot Grading Plan Without Sidewalk

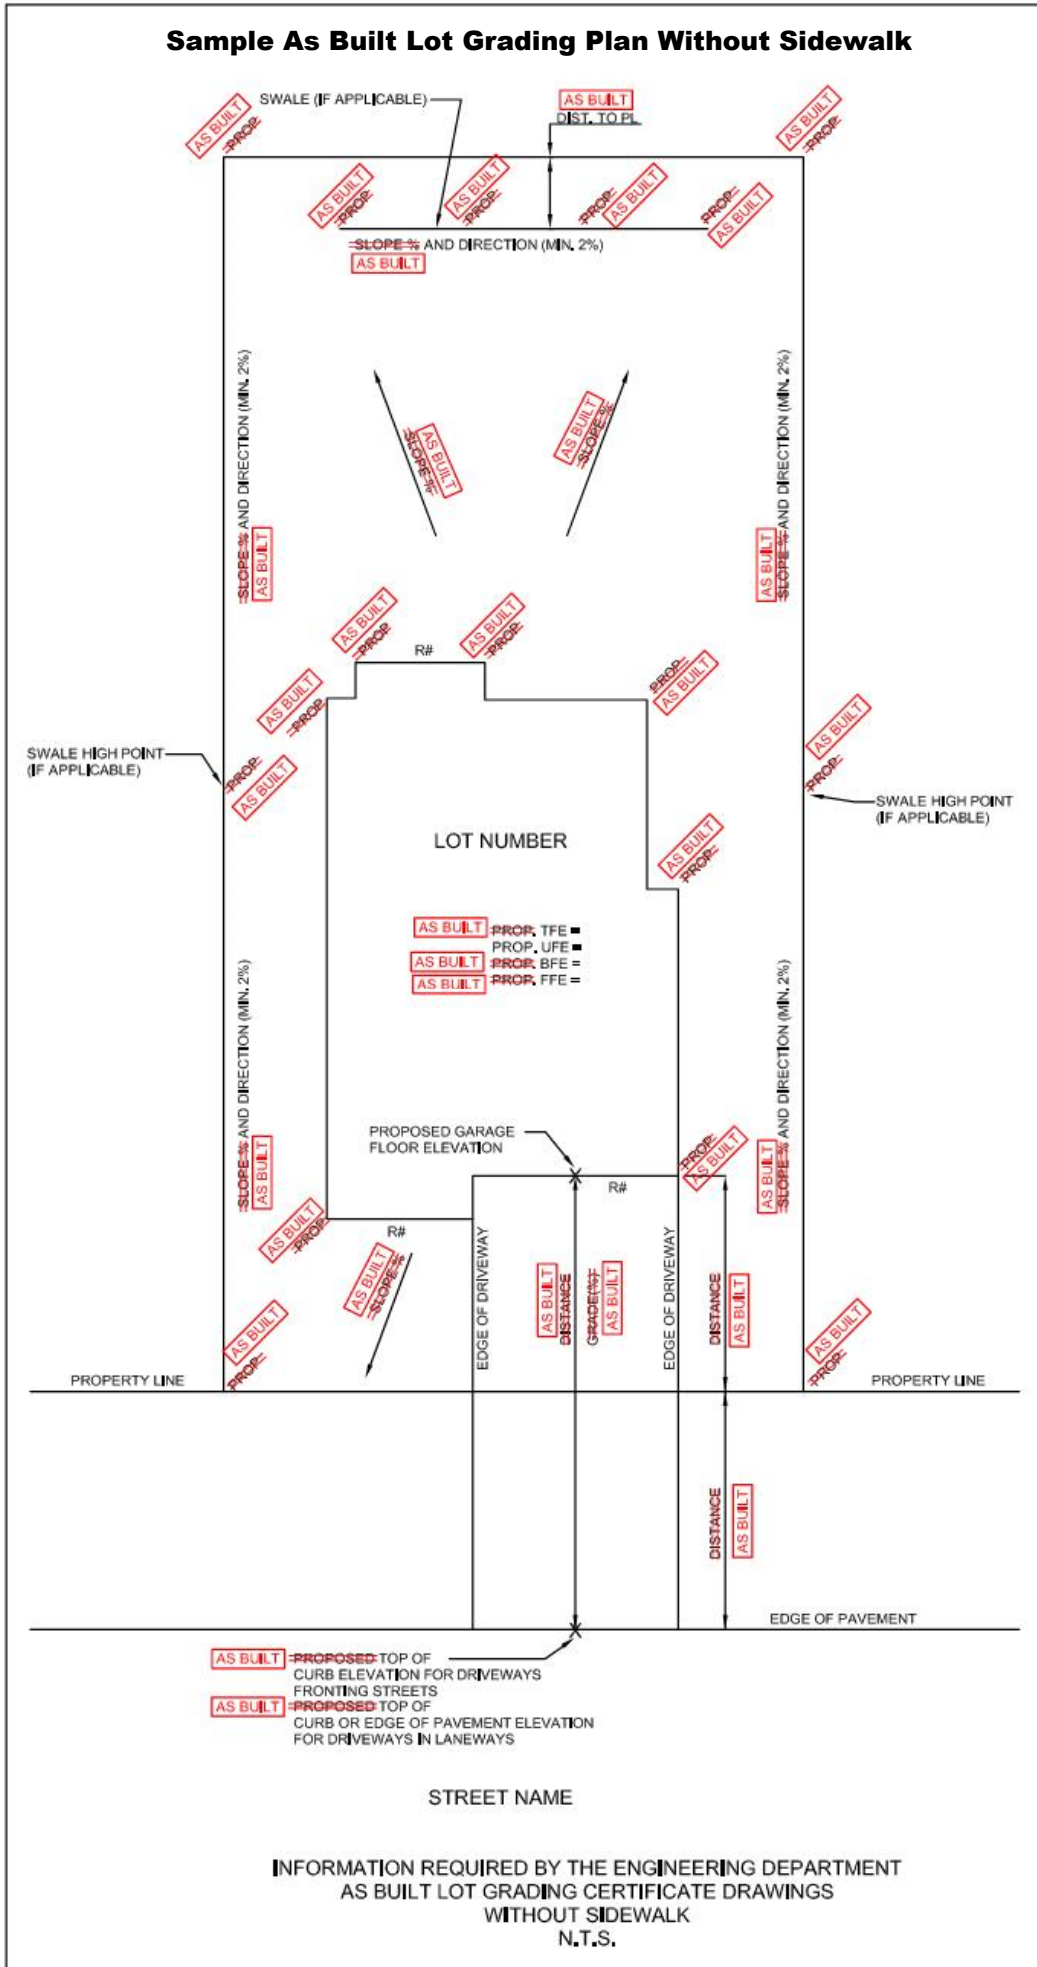

INFORMATION REQUIRED BY THE ENGINEERING DEPARTMENT
 AS BUILT LOT GRADING CERTIFICATE DRAWINGS
 WITHOUT SIDEWALK
 N.T.S.