

- DRAWING LIST
1. EXISTING SITE PLAN
  2. EXISTING BASEMENT PLAN
  3. EXISTING GROUND FLOOR PLAN
  4. EXISTING SECOND FLOOR PLAN
  5. CONCEPT BED LAYOUT

Printed- 9/3/2020

Sept 3, 2020, As Built Drawings with Concept Bed Layouts, 24x18  
 May 13, 2020, As Built Drawings with Concept Bed Layouts  
 April 30, 2020, As Built Drawings for Owner/Planner Comment

date: April 2020  
 scale: 1:250  
 dwg. no. 1

client: CANADIAN CENTRE FOR ADDICTIONS  
 project: AS BUILT SITE and FLOOR PLANS  
 420 Division Street, Cobourg  
 dwg. title: EXISTING SITE PLAN

**Bruce MacNeill Architect**  
 221 Queen Street, Cobourg, Ontario  
 tel/ fax 905-377-1087

THIS DRAWING IS NOT TO BE USED FOR CONSTRUCTION UNLESS SIGNED BY THE ARCHITECT. THE ARCHITECT SHALL BE RESPONSIBLE FOR ANY DISCREPANCIES FOUND PRIOR TO PROCEEDING WITH THE WORK.


**SITE PLAN**  
 All features shown are existing.

THESE PLANS WERE CONSTRUCTED USING THE 1987 ARCHITECTURAL PERMIT PLANS and ON SITE REVIEW CONFIRMING FEATURES AS NOTED BELOW ARE GENERALLY IN THE LOCATIONS SHOWN.

SITE PLAN:  
 BUILDING FOOTPRINT, PARKING AREAS, DRIVEWAYS, WALKWAYS AND LANDSCAPE AREA.

BUILDING PLANS:  
 WALLS, DOORS and WINDOWS.

AS BUILT MEASUREMENTS WERE NOT MADE.

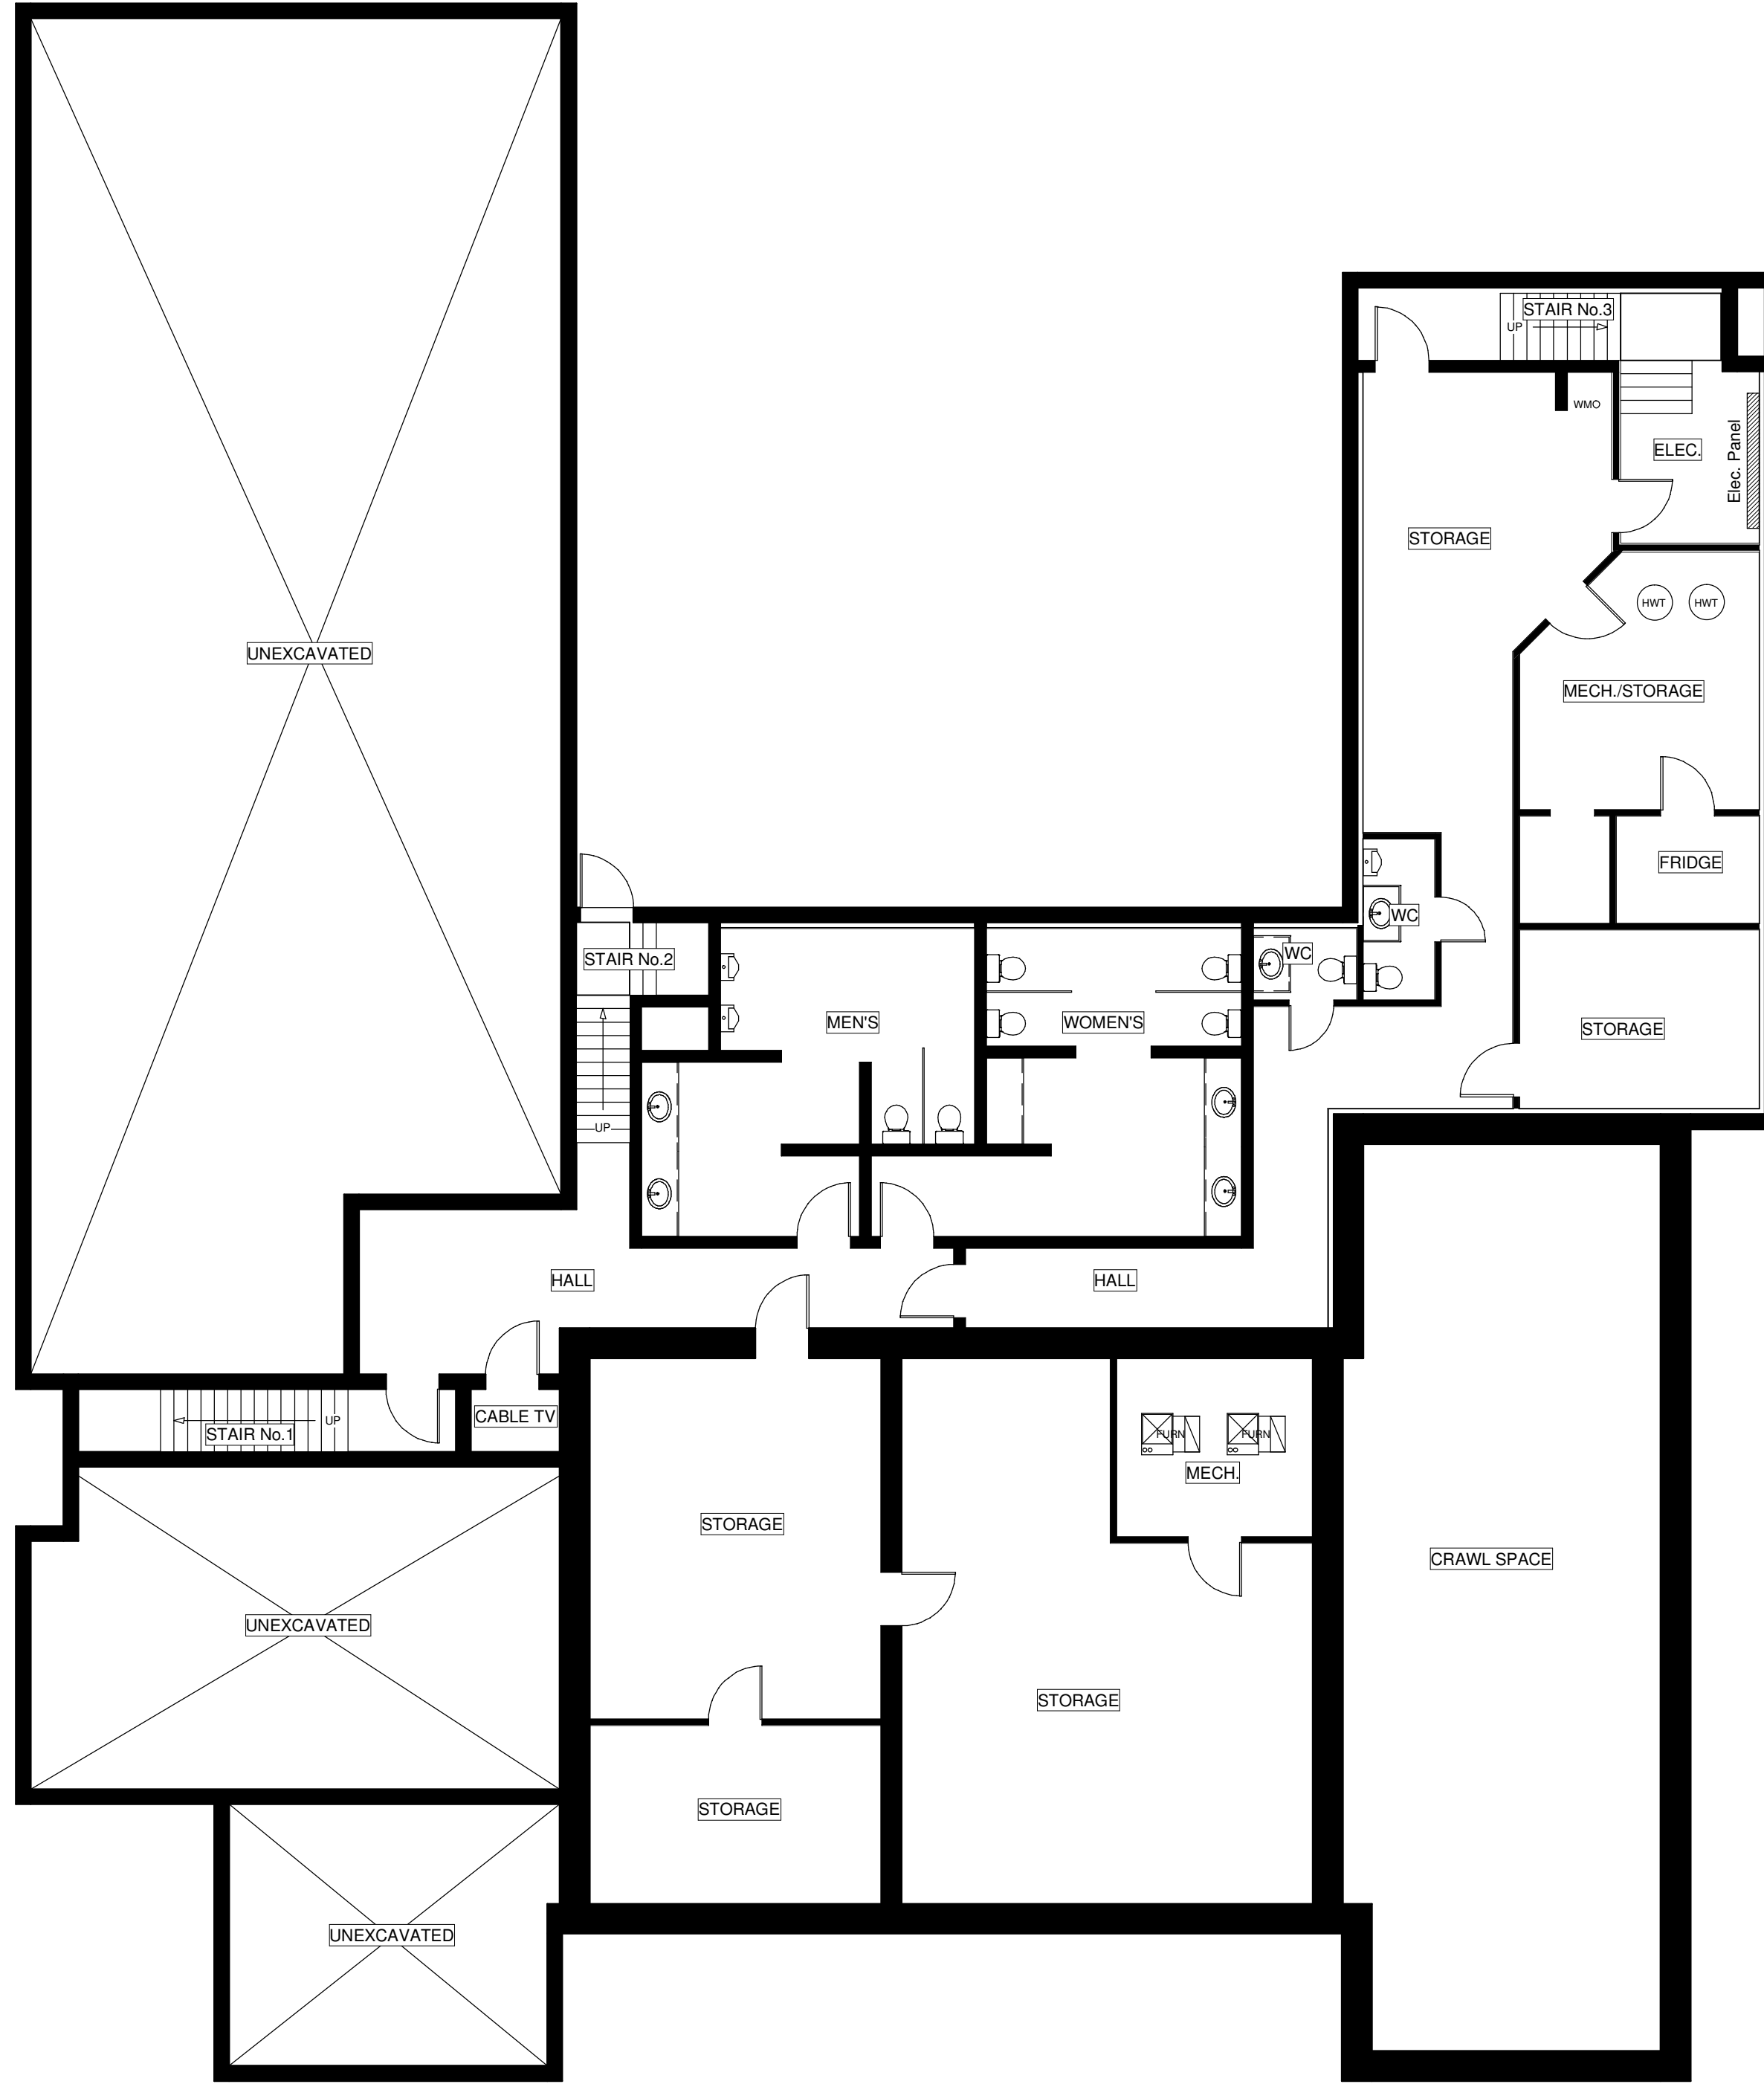

**BASEMENT PLAN**

THESE PLANS WERE CONSTRUCTED USING THE 1987 ARCHITECTURAL PERMIT PLANS and ON SITE REVIEW CONFIRMING FEATURES AS NOTED BELOW ARE GENERALLY IN THE LOCATIONS SHOWN.

SITE PLAN:  
BUILDING FOOTPRINT, PARKING AREAS, DRIVEWAYS, WALKWAYS AND LANDSCAPE AREA.

BUILDING PLANS:  
WALLS, DOORS and WINDOWS.

AS BUILT MEASUREMENTS WERE NOT MADE.

**Bruce MacNeill Architect**  
221 Queen Street, Cobourg, Ontario  
tel/ fax 905-377-1087

THIS DRAWING IS NOT TO BE USED FOR CONSTRUCTION UNLESS SIGNED BY THE ARCHITECT. THE ARCHITECT SHALL BE RESPONSIBLE FOR ANY DISCREPANCIES FOUND PRIOR TO PROCEEDING WITH THE WORK.

client CANADIAN CENTRE FOR ADDICTIONS  
project AS BUILT SITE and FLOOR PLANS  
420 Division Street, Cobourg  
dwg. title EXISTING BASEMENT PLAN

Printed- 9/3/2020

Sept 3, 2020, As Built Drawings with Concept Bed Layouts, 24x18  
May 13, 2020, As Built Drawings with Concept Bed Layouts  
issued: April 30, 2020, As Built Drawings for Owner/Planner Comment

date April 2020  
scale 1/8"= 1'-0"

2

dwg. no.



GROUND FLOOR PLAN

THESE PLANS WERE CONSTRUCTED USING THE 1987 ARCHITECTURAL PERMIT PLANS and ON SITE REVIEW CONFIRMING FEATURES AS NOTED BELOW ARE GENERALLY IN THE LOCATIONS SHOWN.

SITE PLAN:  
BUILDING FOOTPRINT, PARKING AREAS, DRIVEWAYS, WALKWAYS AND LANDSCAPE AREA.

BUILDING PLANS:  
WALLS, DOORS and WINDOWS.

AS BUILT MEASUREMENTS WERE NOT MADE.

**Bruce MacNeill Architect**  
221 Queen Street, Cobourg, Ontario  
tel/ fax 905-377-1087

client CANADIAN CENTRE FOR ADDICTIONS  
project AS BUILT SITE and FLOOR PLANS  
420 Division Street, Cobourg

dwg. title EXISTING GROUND FLOOR PLAN

Sept 3, 2020, As Built Drawings with Concept Bed Layouts, 24x18  
May 13, 2020, As Built Drawings with Concept Bed Layouts  
April 30, 2020, As Built Drawings for Owner/Planner Comment  
date 1/8" = 1'-0"  
scale 1/8" = 1'-0"  
dwg. no. 3

Printed- 9/3/2020

THIS DRAWING IS NOT TO BE USED FOR CONSTRUCTION UNLESS SIGNED  
BY THE ARCHITECT OR HIS AUTHORIZED REPRESENTATIVE. NO RESPONSIBILITY  
SHALL BE ASSUMED FOR ANY DISCREPANCIES FOUND PRIOR TO PROCEEDING WITH THE WORK.



SECOND FLOOR PLAN

THESE PLANS WERE CONSTRUCTED USING THE 1987 ARCHITECTURAL PERMIT PLANS and ON SITE REVIEW CONFIRMING FEATURES AS NOTED BELOW ARE GENERALLY IN THE LOCATIONS SHOWN.

SITE PLAN:  
BUILDING FOOTPRINT, PARKING AREAS, DRIVEWAYS, WALKWAYS AND LANDSCAPE AREA.

BUILDING PLANS:  
WALLS, DOORS and WINDOWS.


AS BUILT MEASUREMENTS WERE NOT MADE.

**Bruce MacNeill Architect**  
221 Queen Street, Cobourg, Ontario  
tel/ fax 905-377-1087

THIS DRAWING IS NOT TO BE USED FOR CONSTRUCTION UNLESS SIGNED BY THE ARCHITECT. THE ARCHITECT SHALL BE RESPONSIBLE FOR ANY DISCREPANCIES FOUND PRIOR TO PROCEEDING WITH THE WORK.

client CANADIAN CENTRE FOR ADDICTIONS  
project AS BUILT SITE and FLOOR PLANS  
420 Division Street, Cobourg  
dwg. title EXISTING SECOND FLOOR PLAN

Printed- 9/3/2020  
Sept 3, 2020, As Built Drawings with Concept Bed Layouts, 24x18  
May 13, 2020, As Built Drawings with Concept Bed Layouts  
April 30, 2020, As Built Drawings for Owner/Planner Comment  
date April 2020  
scale 1/8" = 1'-0"  
dwg. no. 4

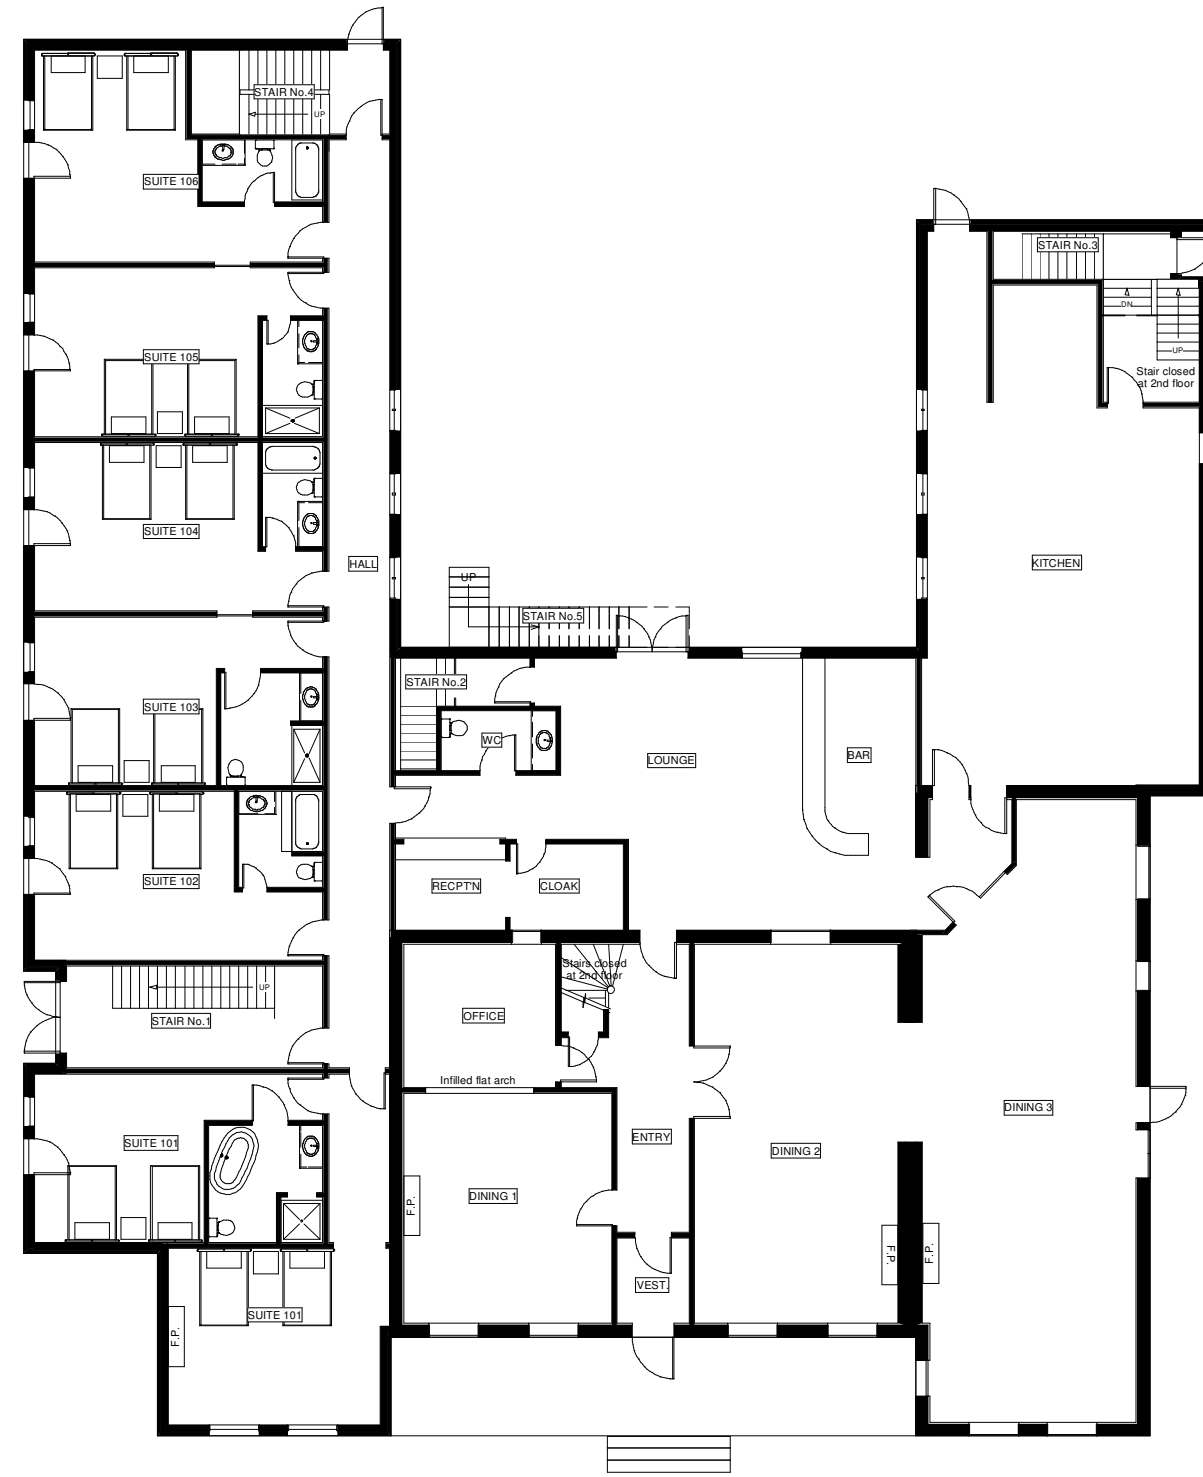

14 'Double' Size Beds this floor

GROUND FLOOR



26 'Double' Size Beds this floor

SECOND FLOOR

Total of 40 Beds Proposed

THESE PLANS WERE CONSTRUCTED USING THE 1987 ARCHITECTURAL PERMIT PLANS and ON SITE REVIEW CONFIRMING FEATURES AS NOTED BELOW ARE GENERALLY IN THE LOCATIONS SHOWN.

SITE PLAN:  
BUILDING FOOTPRINT, PARKING AREAS, DRIVEWAYS, WALKWAYS AND LANDSCAPE AREA.

BUILDING PLANS:  
WALLS, DOORS and WINDOWS.

AS BUILT MEASUREMENTS WERE NOT MADE.

**Bruce MacNeill Architect**  
221 Queen Street, Cobourg, Ontario  
tel/ fax 905-377-1087

THIS DRAWING IS NOT TO BE USED FOR CONSTRUCTION UNLESS SIGNED  
BY THE ARCHITECT. THE ARCHITECT SHALL BE RESPONSIBLE FOR ANY  
DISCREPANCIES FOUND PRIOR TO PROCEEDING WITH THE WORK.

client CANADIAN CENTRE FOR ADDICTIONS  
project AS BUILT SITE and FLOOR PLANS  
420 Division Street, Cobourg  
CONCEPT BED LAYOUT  
dwg. title

Sept 3, 2020, As Built Drawings with Concept Bed Layouts, 24x18  
May 13, 2020, As Built Drawings with Concept Bed Layouts  
April 30, 2020, As Built Drawings for Owner/Planner Comment  
issued:  
date April 2020  
scale 1/16" = 1'-0"  
dwg. no. 5