Sample As Built Lot Grading Plan With Sidewalk

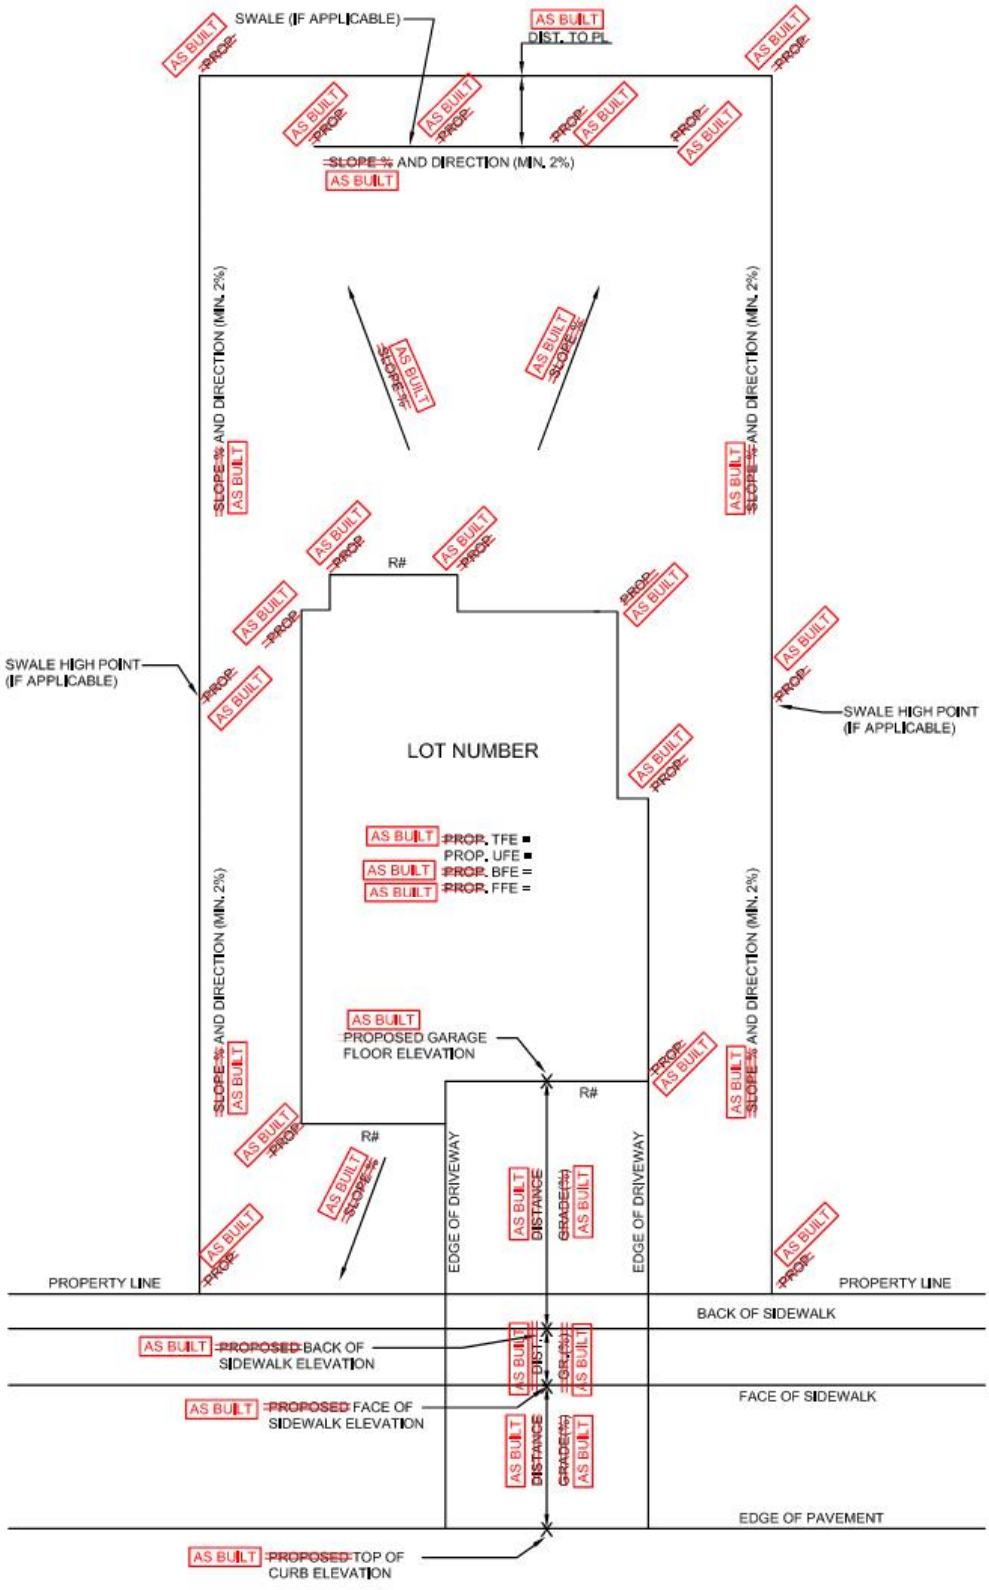

INFORMATION REQUIRED BY THE ENGINEERING DEPARTMENT
AS BUILT LOT GRADING CERTIFICATE DRAWINGS
WITH SIDEWALK
N.T.S.